
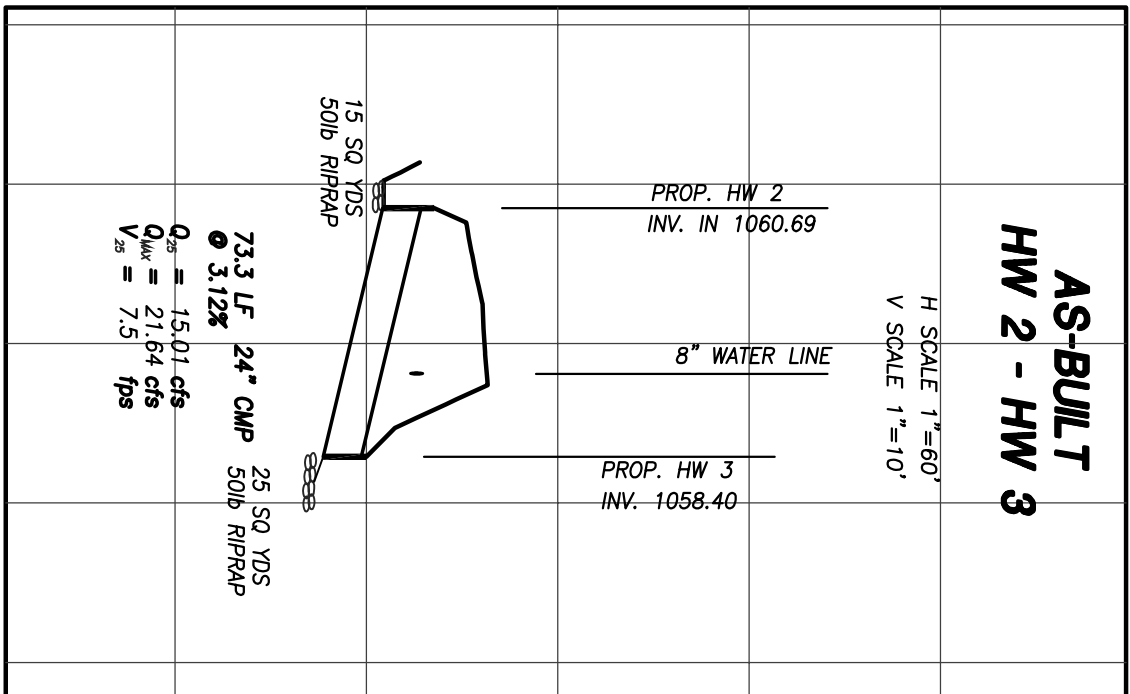
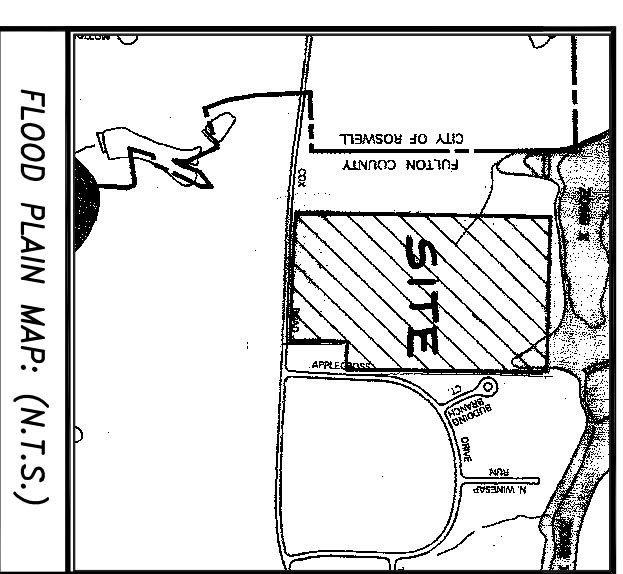
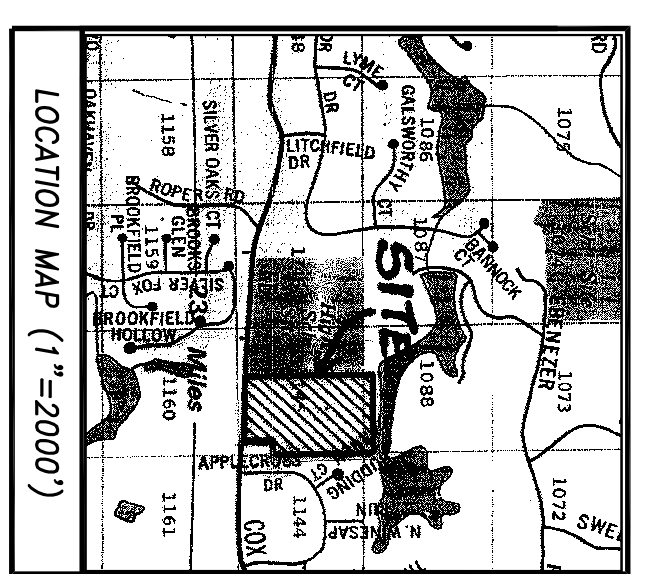


UTILITIES PROTECTION CENTER

CALL FREE
IN METRO ATLANTA
770-553-4369
770-553-4369
1-800-282-7411

CAUTION


THE UTILITIES SHOWN ARE SHOWN FOR THE CONVEYANCE OF THE LAND ONLY. THE ENGINEER HAS CONDUCTED VISUAL INSPECTIONS OF THE UTILITIES SHOWN ON THESE PLANS. THE ENGINEER'S RESPONSIBILITY IS TO ADVISE THE CLIENT OF THE LIMITS OF THE WORK. ALL DAMAGE MADE TO EXISTING UTILITIES SHALL BE THE RESPONSIBILITY OF THE CONTRACTOR.

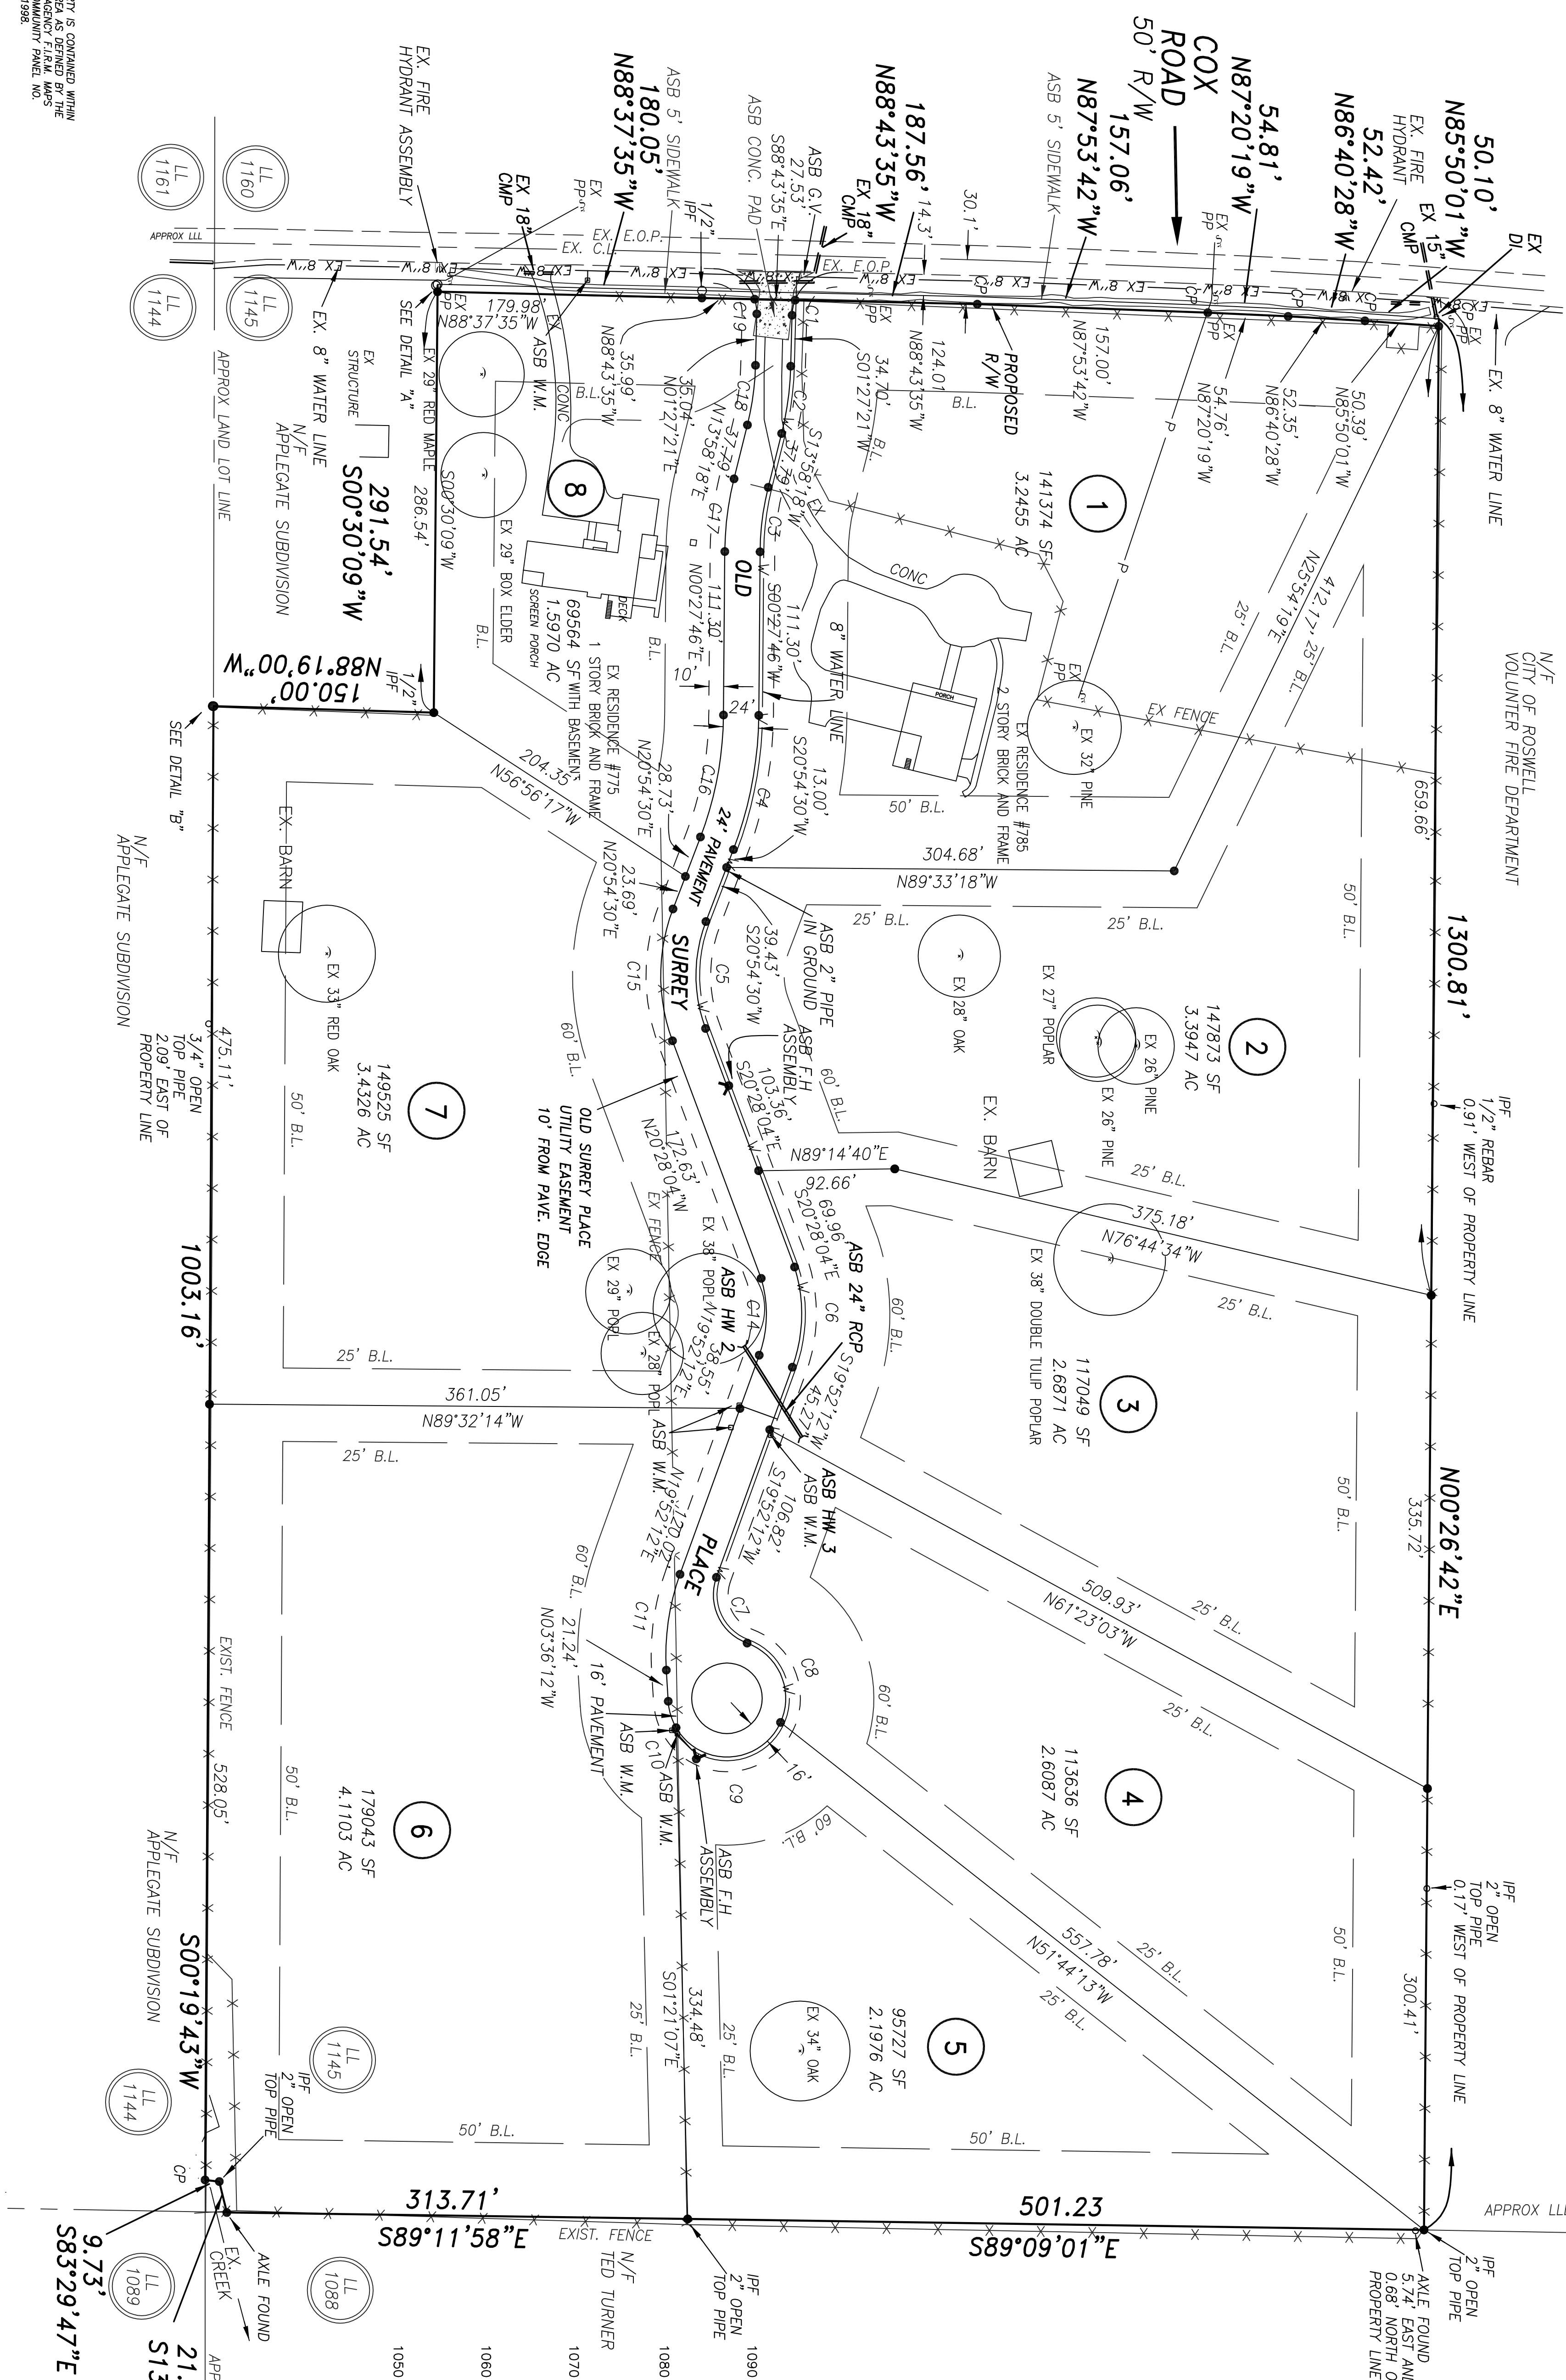

A PORTION OF THE SUBJECT PROPERTY IS CONTAINED WITHIN THE LIMITS OF A FLOOD HAZARD AREA AS DEFINED BY THE FLOOD INSURANCE RATE MAP (FIRM) NO. 13121C-0034-E DATED JUNE 22, 1998.

BOUNDARY ADJUSTMENT REFERENCES A SURVEY FOR SUTHERCRAFT HOMES BY JAMES H. SMITH, JR., SUTHERCRAFT HOMES, INC., DATED 10-30-2001, REG. SURVEYOR #1965.

TOPOGRAPHY FROM FIELD WORK DATED 5/03/02

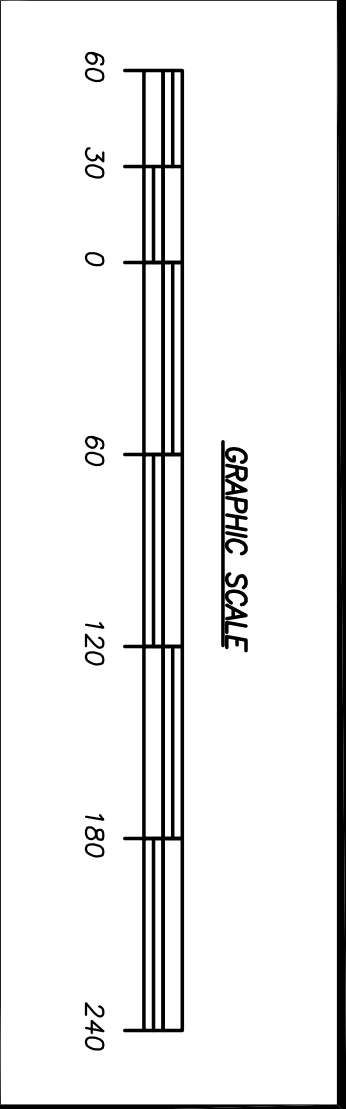

REV.	DATE	DESCRIPTION

ALL MATERIALS AND CONSTRUCTION SHALL CONFORM TO THE STANDARDS OF FULTON COUNTY

ASBUILT PLAN FOR:
COX ROAD

LAND LOT 1145, 2ND DISTRICT, 2ND SECTION, FULTON COUNTY, GEORGIA

DRAWN	AS
CHECKED	LCE
DATE	5-28-03
SCALE	1" = 60'

LCE ENGINEERS, INC.

1265 Canton Street
Suite A
Roswell, GA 30077

OWNER/SUBDIVIDER:
SUTHERCRAFT HOMES
702 MACY DRIVE
DUNWOODY, GA 30015
PHONE (770) 998-3338
MR. HARVEY SMITH

24 HOUR CONTACT
HARVEY SMITH
Phone 770-998-3339

Tel.(770) 998-5763

SHEET